




THIS DRG IS THE SOLE PROPERTY OF ECS PVT. LTD.
UNAUTHORISED USE OF THIS DRG OR MAKING PRODUCT AS PER OUR DRG
WITHOUT OUR PERMISSION OR ANY OTHER MISUSE IS NOT PERMITTED.

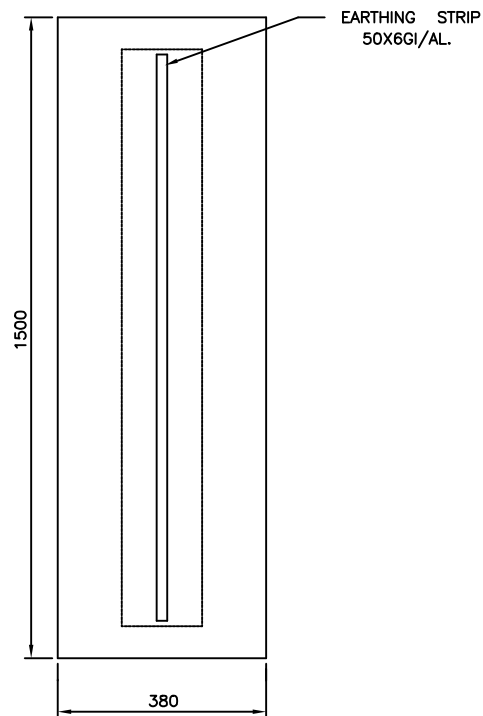


SIDE VIEW

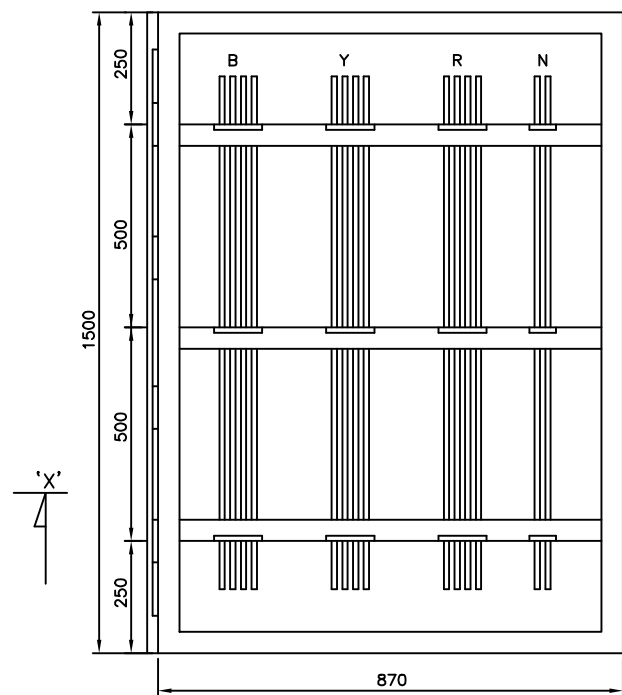


TOP VIEW (WITH OUT COVER)

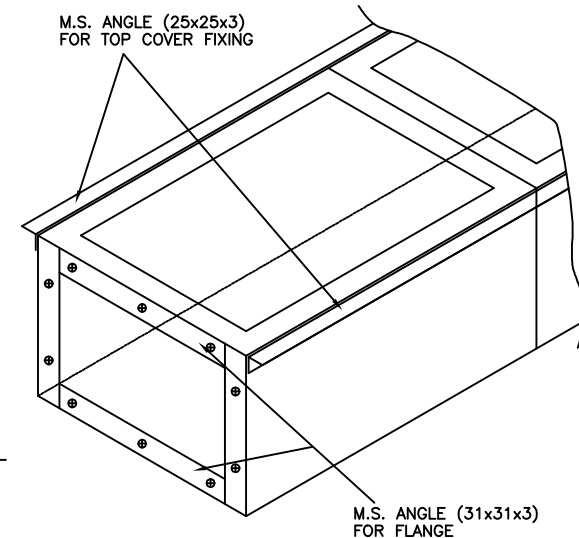

ISOMETRIC VIEW

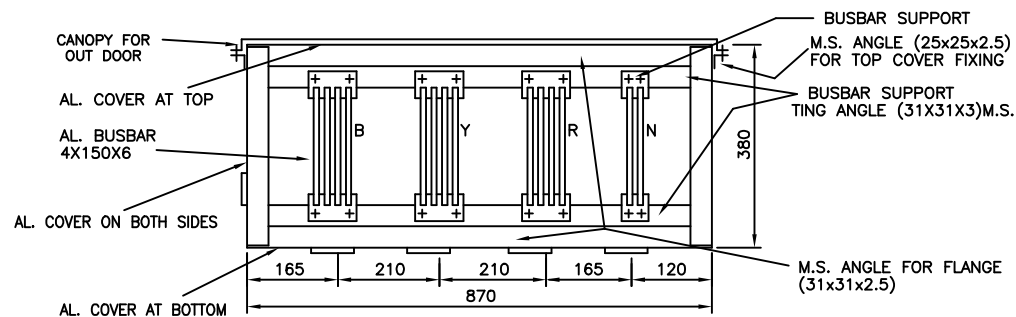

SECTION X-X

				CLIENT	M/S L&T	DRN.	AKS	1.10.93		ELECTRIC CONTROLS & SWITCHBOARDS (P) LTD. D-6, SEC.VIII, NOIDA-201 301 (U.P.)		
						CHD.	ANQ	2.10.93				
				CONSULTANT	M/S N.T.P.C.	APPD.			TITLE	G.A. DRG FOR BUS DUCT CONSTRUCTION (STRAIGHT LENGTH) (TYP.)		
2	21.5.93	AKS	AS BUILT DRG.			SCALE	N.T.S.					
1	12.10.93	AKS	AS PER MOM DTD. 4.12.93	PROJECT	N.T.P.C. GANDHAR GAS BASED COMBINED CYCLE PLANT	JOB NO. 919			DRG. NO.	919-301-01		SHEET 1 OF 5
REV NO	DATE	DRN	REVISION			TOTAL SHT OF						